

OTTAWA COUNTY ENGINEERS OFFICE

REFERENCE NO. 2-6-13-F
 EAST QUARTER POST SEC. 2
 CLAY TWP.
 SHEET 1 OF 1.

ROUTE: T-214 OPFER-LENTZ RD.
 @ T-56 FULKERT RD.

TOWNSHIP: CLAY


SECTION: 2

T 6 NR 13 E.

NORTHING:

EASTING:

DATUM:

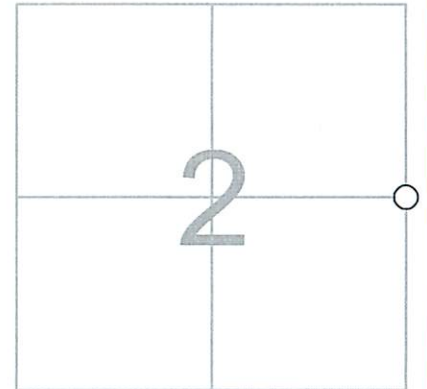

PERSONNEL:
 M. WITTMAN, P.S.
 J. ALLEN

DATE / WEATHER / TEMP:
 JULY 5, 2016
 PTLY SUNNY - SW
 85° F - HUMID

MONUMENT INFORMATION

MONUMENT TYPE: FD 1" SQ. IRON PIN IN CLAY TILE
 ON SURFACE - BELOW: 0.15'
LEFT - CL PAV'T - RIGHT: 2.5' (FULKERT RD.)
LEFT - CL PAV'T - RIGHT: 4.00' (OPFER-LENTZ RD.)

 SET DRILL HOLE IN CENTER OF IRON PIN.



MISC. INFORMATION

THIS MONUMENT IS PER COUNTY RECORDS. CUT
 OF THE TOP 3.5" OF CLAY TILE AND DROVE IRON
 PIN DOWN 2.5" SO A MONUMENT BOX COULD BE
 SET OVER THIS POINT.

JULY 5, 2016

SET MONUMENT BOX OVER
 IRON PIN IN CLAY TILE

