

OTTAWA COUNTY ENGINEERS OFFICE

REFERENCE NO. 2-6-13-G
SW CORNER SECTION 2
CLAY TWP.
SHEET 1 OF 1.

ROUTE: T-7 MARTIN-WILLISTON RD.
@ T-4 CAMPER RD.

TOWNSHIP: CLAY

SECTION: 2

T 6 NR 13 E.

NORTHING:

EASTING:


DATUM:

PERSONNEL:

J. ALLEN
M. ULLRICH
S. ULLRICH

DATE / WEATHER / TEMP:

AUGUST 28, 2008
CLOUDY
65° F

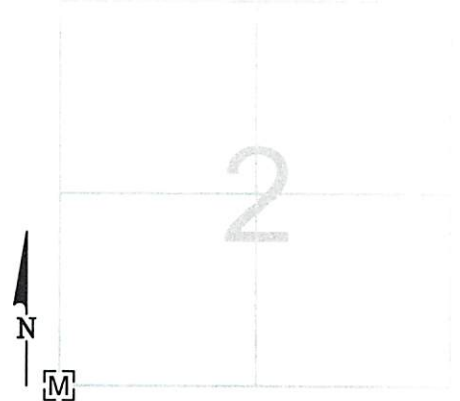

MONUMENT INFORMATION

MONUMENT TYPE: FD. 1 $\frac{1}{8}$ " IRON PIN W/ DRILL
HOLE IN MONUMENT BOX
ON SURFACE - BELOW: 0.26'
LEFT - CL PAVT - RIGHT: 1.0'



MISC. INFORMATION

