

OTTAWA COUNTY ENGINEERS OFFICE

REFERENCE NO. 20-7-13-B
NORTH QUARTER POST SEC. 20
CLAY TWP.

SHEET 1 OF 1.

PERSONNEL:

M. WITTMAN, P.S.
J. ALLEN
C. MILLER, E.KOCH
T. RAHM, K. LENKE - GARAGE

DATE / WEATHER / TEMP:

JULY 14, 2009
SUNNY
70° F

ROUTE: C-66 MOLINE-MARTIN RD.

TOWNSHIP: CLAY


SECTION: 20

T 7 NR 13 E.

NORTHING:

EASTING:

DATUM:

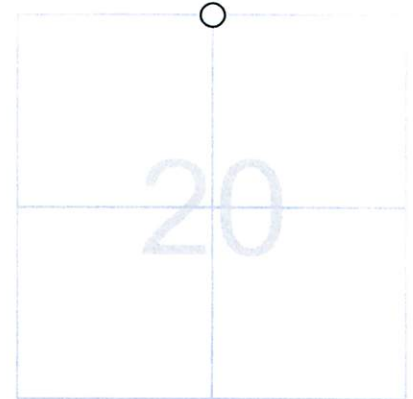

MONUMENT INFORMATION

MONUMENT TYPE: FD 1" Ø IRON PIN
ON SURFACE - BELOW: 1.81'
LEFT - CL PAV'T - RIGHT: 5.80'

WOOD HUB SET ON EAST SIDE OF PIN.



MISC. INFORMATION

FD. PK NAIL 0.30' BELOW SURFACE. TIED W/
CROSS TIES AND DUG FOR IRON PIN PER
RECORDS. PK NAIL WAS 0.09' NORTH AND 0.21'
EAST OF IRON PIN.

JULY 14, 2009

SET 1" SQUARE IRON PIN
IN MONUMENT BOX OVER
1" Ø IRON PIN

