

# OTTAWA COUNTY ENGINEERS OFFICE

REFERENCE NO. 20-7-13-G  
SW CORNER SECTION 20  
CLAY TWP.  
SHEET 1 OF 1.

ROUTE: T-54 BILLMAN RD.  
@ T-65 HELLWIG RD.

TOWNSHIP: CLAY

SECTION: 20

T 7 NR 13 E.


NORTHING:

EASTING:

DATUM:

PERSONNEL:  
J. ALLEN  
M. ULLRICH  
S. ULLRICH

DATE / WEATHER / TEMP:  
AUGUST 29, 2008  
CLOUDY  
77° F

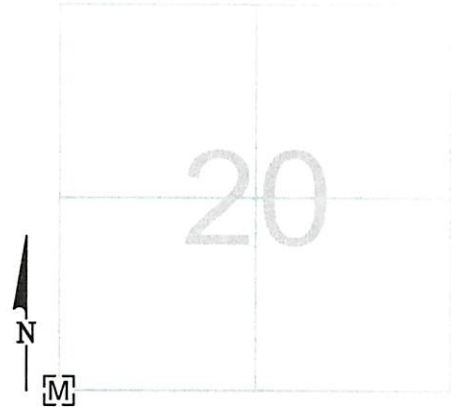

## MONUMENT INFORMATION

MONUMENT TYPE: FD. 1" Ø IRON PIN IN  
MONUMENT BOX  
ON SURFACE - BELOW: 0.26'  
LEFT - CL PAV'T - RIGHT:



## MISC. INFORMATION

AUGUST 29, 2008

BROUGHT TO SURFACE

