

OTTAWA COUNTY ENGINEERS OFFICE

REFERENCE NO. 20-7-13-H
SOUTH QUARTER POST SEC. 20
CLAY TWP.
SHEET 1 OF 1.

ROUTE: T-65 HELLWIG RD.

TOWNSHIP: CLAY

SECTION: 20

T 7 NR 13 E.

PERSONNEL:
M. WITTMAN, P.S.
J. ALLEN


NORTHING:

EASTING:

DATUM:

DATE / WEATHER / TEMP:

NOVEMBER 3, 2009
SUNNY - SW
47° F

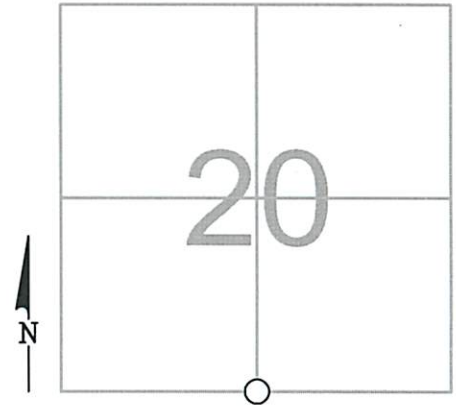

MONUMENT INFORMATION

MONUMENT TYPE: FD. 1" SQ. IRON PIN
ON SURFACE - BELOW: 0.05'
LEFT - CL PAV'T - RIGHT: 4.10'

MISC. INFORMATION

DROVE PIN STRAIGHT DOWN 4" TO FIT MONUMENT
BOX OVER



NOVEMBER 2, 2009

SET MONUMENT BOX OVER
1" SQ. IRON PIN

