

OTTAWA COUNTY ENGINEERS OFFICE

REFERENCE NO. 20-7-13-1
SE CORNER SECTION 20
CLAY TWP.
SHEET 1 OF 1.

PERSONNEL:
M. WITTMAN, P.S.
J. ALLEN
B. JEFFRIES

DATE / WEATHER / TEMP:
AUGUST 26, 2008
SUNNY E
77° F

ROUTE: T-53 REIMAN RD.
@ T-65 HELLWIG RD.

TOWNSHIP: CLAY


SECTION: 20

T 7 N R 13 E.

NORTHING:

EASTING:

DATUM:

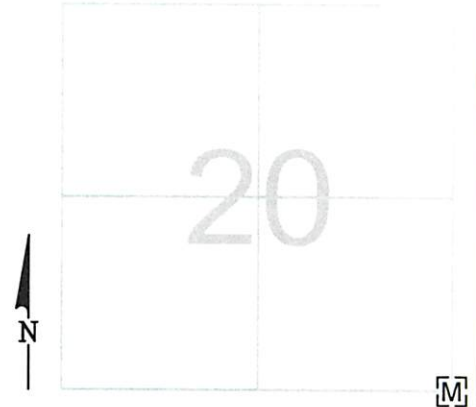

MONUMENT INFORMATION

MONUMENT TYPE: FD. 1" SQUARE IRON PIN IN
MONUMENT BOX
ON SURFACE - BELOW:
LEFT - CL PAVT - RIGHT:



MISC. INFORMATION

