

OTTAWA COUNTY ENGINEERS OFFICE

REFERENCE NO. 21-7-13-B
NORTH QUARTER POST SEC. 21
CLAY TWP.
SHEET 1 OF 1.

ROUTE: C-66 MOLINE-MARTIN RD. @
C-72 BOLANDER RD.

TOWNSHIP: CLAY

SECTION: 21

T 7 N R 13 E.

NORTHING:

EASTING:


DATUM:

PERSONNEL:

M. WITTMAN, P.S.
J. ALLEN
C. MILLER, E. KOCH
T. RAHM, D. BROUGH - GARAGE

DATE / WEATHER / TEMP:

JULY 13, 2009
SUNNY
65° F

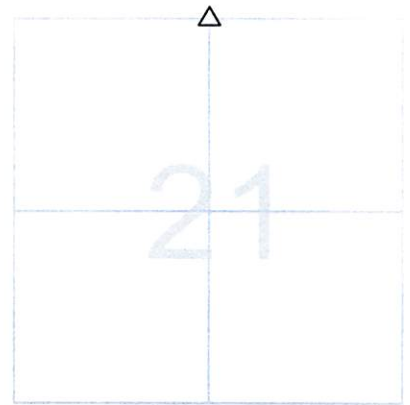

MONUMENT INFORMATION

MONUMENT TYPE: FD HARDHEAD STONE
ON SURFACE - BELOW: 2.15'
LEFT - CL PAV'T - RIGHT: 1.55'
RECTANGULAR STONE: 6" x 4"

USED DEPRESSION IN CENTER OF STONE.



MISC. INFORMATION

FD. RAILROAD SPIKE 0.35' BELOW SURFACE.
TIED W/ CROSS TIES AND DUG FOR STONE. FD.
CONCRETE IN CLAY TILE 1.65' BELOW SURFACE.
CLAY TILE WAS 3" INSIDE DIAMETER AND 6' TALL
CENTERED OVER STONE. RAILROAD SPIKE
WAS 0.09' EAST AND 0.12' SOUTH.

JULY 13, 2009

SET 1" SQUARE IRON PIN
IN MONUMENT BOX OVER
STONE

