


OTTAWA COUNTY ENGINEERS OFFICE

REFERENCE NO. 21-7-13-H
 SOUTH QUARTER POST SEC. 21
 CLAY TWP.
 SHEET 1 OF 1.

ROUTE: T-65 HELLWIG RD.
 TOWNSHIP: CLAY
 SECTION: 21
 T 7 NR 13 E.

PERSONNEL:
 M. WITTMAN, P.S.
 J. ALLEN

NORTHING:
 EASTING:
 DATUM:

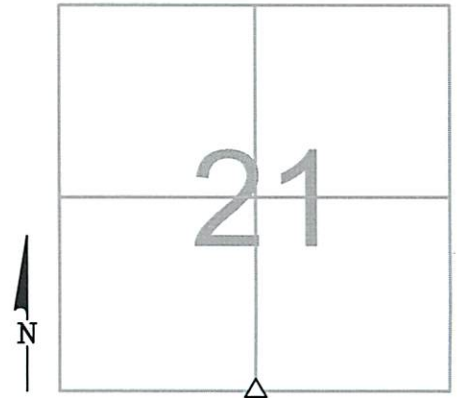

DATE / WEATHER / TEMP:
 NOVEMBER 5, 2009
 SUNNY - W-NW
 45° F

MONUMENT INFORMATION

MONUMENT TYPE: FD. 3-1/2"x5" TRIANGULAR STONE
 WITH DRILL HOLE
 ON SURFACE - BELOW: 1.00'
 LEFT - CL PAV'T - RIGHT: 5.85'

 USED DRILL HOLE



MISC. INFORMATION

FD. 1" Ø IRON PIPE AT SURFACE. TIED WITH X-TIES
 AND DUG FOR STONE. IRON PIPE WAS DRIVEN ON
 WEST SIDE OF STONE AND BENT OVER THE
 CENTER OF STONE. TOP OF PIPE WAS 0.09'W AND
 0.09' N OF THE DRILL HOLE. PULLED PIPE AND SET
 1" SQ. IRON PIN IN MONUMENT BOX.

NOVEMBER 5, 2009

SET 1" SQUARE IRON PIN
 IN MONUMENT BOX OVER
 STONE

