

OTTAWA COUNTY ENGINEERS OFFICE

REFERENCE NO. 22-7-13-B
NORTH QUARTER POST SEC. 22
CLAY TWP.
SHEET 1 OF 1.

ROUTE: C-66 MOLINE-MARTIN RD.

TOWNSHIP: CLAY

SECTION: 22

T 7 NR 13 E.

PERSONNEL:

M. WITTMAN, P.S.
J. ALLEN
E. KOCH, C. MILLER
T. RAHM, D. BROUGH - GARAGE


NORTHING:

EASTING:

DATE / WEATHER / TEMP:

JULY 13, 2009
SUNNY
61° F

DATUM:

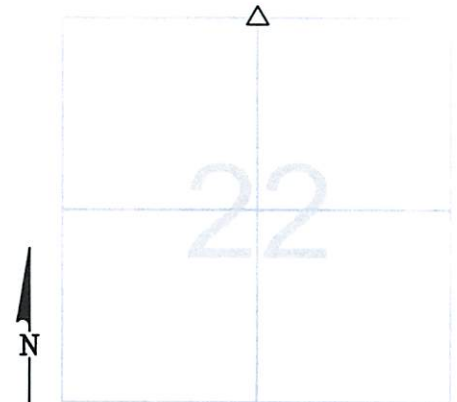

MONUMENT INFORMATION

MONUMENT TYPE: FD HARDHEAD STONE
ON SURFACE - BELOW: 1.90'
LEFT - CL PAV'T - RIGHT:
TRIANGULAR STONE: 3 1/2" x 3"

USED HIGHPOINT ON STONE.



MISC. INFORMATION

JULY 13, 2009

SET 1" SQUARE IRON PIN
IN MONUMENT BOX OVER
STONE

