

OTTAWA COUNTY ENGINEERS OFFICE

REFERENCE NO. 22-7-13-D
WEST QUARTER POST SEC. 22
CLAY TWP.
SHEET 1 OF 1.

PERSONNEL:
M. WITTMAN, P.S.
J. ALLEN

DATE / WEATHER / TEMP:
OCTOBER 6, 2008
OVERCAST
62° F

ROUTE: C-51 GENOA-CLAY CENTER RD.

TOWNSHIP: CLAY


SECTION: 22

T 7 NR 13 E.

NORTHING:


EASTING:

DATUM:

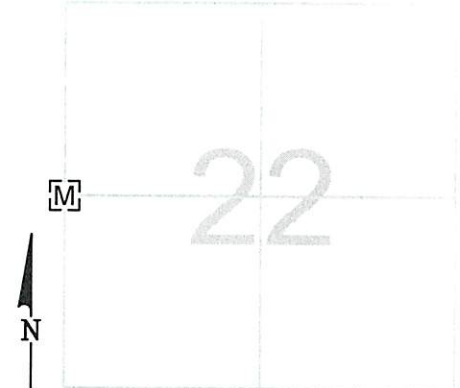

MONUMENT INFORMATION

MONUMENT TYPE: FD. 1" SQUARE IRON PIN W/
DRILL HOLE IN MONUMENT BOX
ON SURFACE - BELOW: 0.53'
LEFT - CL PAV'T - RIGHT: 0.70'

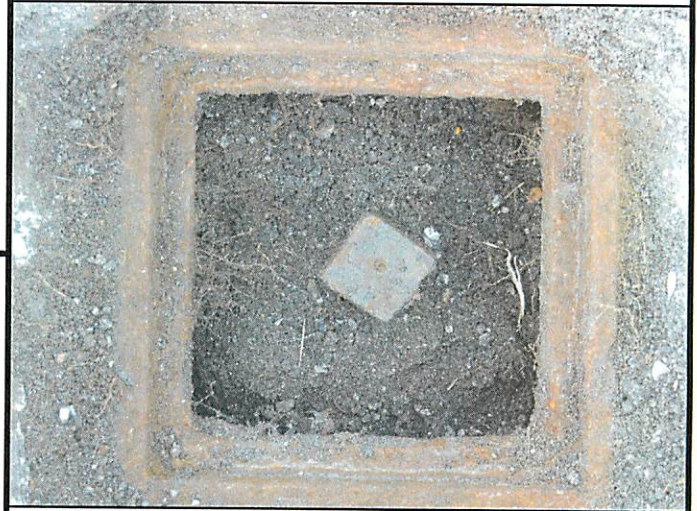

MISC. INFORMATION

