

# OTTAWA COUNTY ENGINEERS OFFICE

REFERENCE NO. 22-7-13-I  
SE CORNER POST SEC. 22  
CLAY TWP.  
SHEET 1 OF 1.

ROUTE: T-65 HELLWIG RD.  
@ C-7 MARTIN - WILLISTON RD.

TOWNSHIP: CLAY

SECTION: 22

T 7 N R 13 E.


NORTHING:

EASTING:

DATUM:

PERSONNEL:  
M. WITTMAN, P.S.  
J. ALLEN

DATE / WEATHER / TEMP:  
DECEMBER 3, 2009  
OVERCAST - W  
41° F

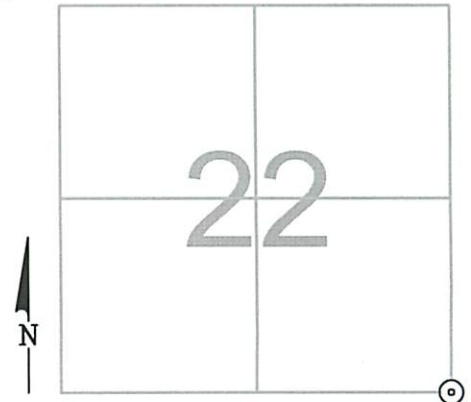

## MONUMENT INFORMATION

MONUMENT TYPE: FD. 3/8" IRON BOLT IN CONC.  
ON SURFACE - BELOW: 0.73'  
LEFT - CL PAV'T - RIGHT: 6.50'



## MISC. INFORMATION

BOLT (PIN) IN CONCRETE PER COUNTY RECORDS  
WPA BOOK 1 PAGE 77

DECEMBER 3, 2009

SET MONUMENT BOX OVER  
BOLT IN CONCRETE

