

# OTTAWA COUNTY ENGINEERS OFFICE

REFERENCE NO. 23-7-13-A  
NW CORNER POST SEC. 23  
CLAY TWP.  
SHEET 1 OF 1.

ROUTE: T-7 MARTIN-WILLISTON RD.

TOWNSHIP: CLAY

SECTION: 23

T 7 NR 13 E.

PERSONNEL:  
M. WITTMAN, P.S.  
J. ALLEN

NORTHING:

EASTING:

DATUM:

DATE / WEATHER / TEMP:

OCTOBER 8, 2012  
SUNNY - SW  
50° F



## MONUMENT INFORMATION


MONUMENT TYPE: FD. HARDHEAD STONE W/ DH  
ON SURFACE - BELOW: 1.73'  
LEFT - CL PAV'T - RIGHT: 3.70'

IRREGULAR SHAPED STONE 8" N/S x 6" E/W



## MISC. INFORMATION

FD. RAILROAD SPIKE 0.10' BELOW SURFACE TIED  
W/ X-TIES AND DUG FOR STONE. RAILROAD SPIKE  
FIT DH IN STONE.

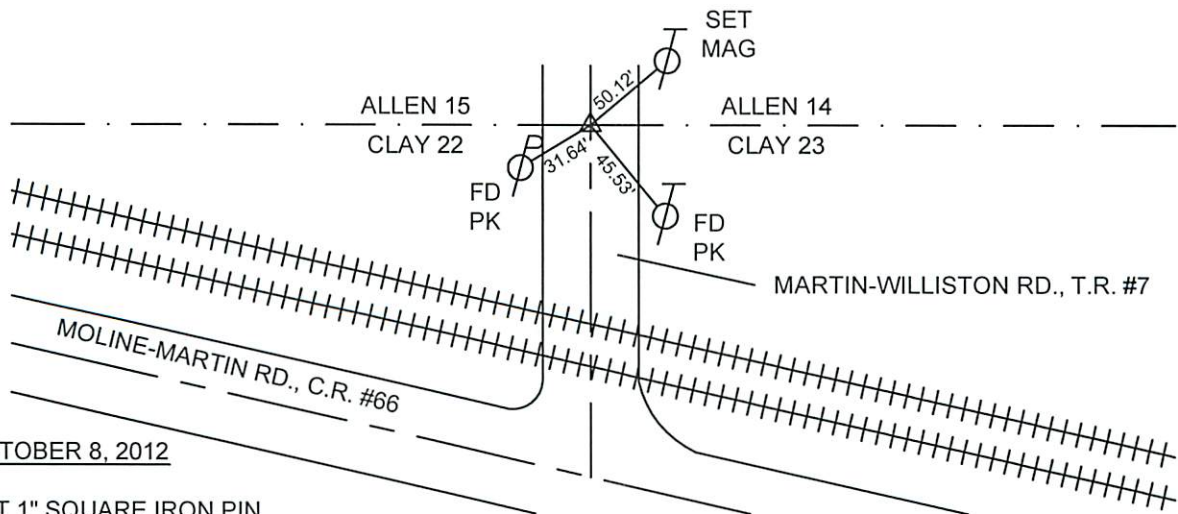

OCTOBER 8, 2012

SET 1" SQUARE IRON PIN  
IN MONUMENT BOX OVER  
STONE