

OTTAWA COUNTY ENGINEERS OFFICE

REFERENCE NO. 23-7-13-H
SOUTH QUARTER POST SEC. 23
CLAY TWP.
SHEET 1 OF 1.

ROUTE: T-65 HELLWIG RD.

TOWNSHIP: CLAY

SECTION: 23

T 7 N R 13 E.

PERSONNEL:
M. WITTMAN, P.S.
J. ALLEN


NORTHING:

EASTING:

DATUM:

DATE / WEATHER / TEMP:

DECEMBER 3, 2009
CLDY - W
43° F

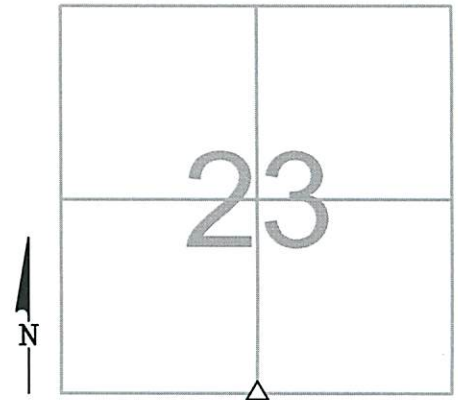

MONUMENT INFORMATION

MONUMENT TYPE: FD. 7"x8-1/2" FLAT TRIANGULAR
LIMESTONE
ON SURFACE - BELOW: 1.69'
LEFT - CL PAV'T - RIGHT: 3.50'

USED CENTER OF STONE



MISC. INFORMATION

FD. PK NAIL 0.18' BELOW SURFACE, TIED WITH
X-TIES AND DUG FOR STONE. PK NAIL WAS 1.2' W
AND 0.55' S OF CENTER OF STONE.

DECEMBER 3, 2009

SET 1" SQUARE IRON PIN
IN MONUMENT BOX OVER
STONE

