

# OTTAWA COUNTY ENGINEERS OFFICE

REFERENCE NO. 24-7-13-C  
NORTHEAST COR. POST SEC. 24  
CLAY TWP.  
SHEET 1 OF 1.

ROUTE: C-213 NISSEN RD.  
@ C-66 MOLINE MARTIN RD.

TOWNSHIP: CLAY

SECTION: 24

T 7 NR 13 E.

NORTHING:


EASTING:

DATUM:

PERSONNEL:  
M. WITTMAN, P.S.  
J. ALLEN

DATE / WEATHER / TEMP:

MAY 21, 2012  
SUNNY E-NE  
83° F

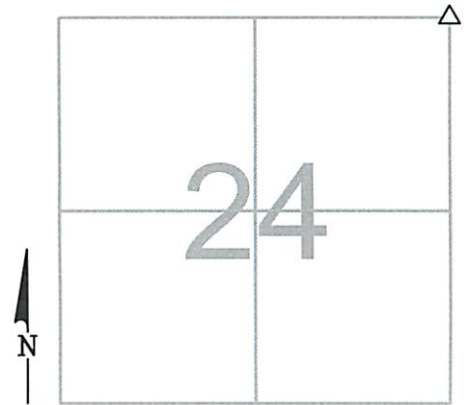

## MONUMENT INFORMATION

MONUMENT TYPE: FD. 14" X 15" HARDHEAD STONE  
ON SURFACE - BELOW: 2.50'  
LEFT - CL PAV'T - RIGHT: 2.10'

RECTANGULAR STONE

USED HIGH POINT IN CENTER OF STONE



## MISC. INFORMATION

FD. RAILROAD SPIKE IN WOODEN HUB 0.4' BELOW  
SURFACE. TIED W/ X-TIES AND DUG FOR STONE.  
RAILROAD SPIKE WAS 0.15' WEST OF POINT USED  
ON STONE.

SET IRON PIN HAS A SLIGHT N-NE LEAN AFTER  
INSTALLATION.

MAY 21, 2012

SET 1" SQUARE IRON PIN  
IN MONUMENT BOX OVER  
STONE

