

# OTTAWA COUNTY ENGINEERS OFFICE

REFERENCE NO. 24-7-13-F  
EAST QUARTER POST SEC. 24  
CLAY TWP.  
SHEET 1 OF 1.

ROUTE: C-213 NISSEN RD.

TOWNSHIP: CLAY

SECTION: 24

T 7 NR 13 E.


NORTHING:

EASTING:

DATUM:

PERSONNEL:  
M. WITTMAN, P.S.  
J. ALLEN

DATE / WEATHER / TEMP:  
MAY 21, 2012  
SUNNY E  
76° F

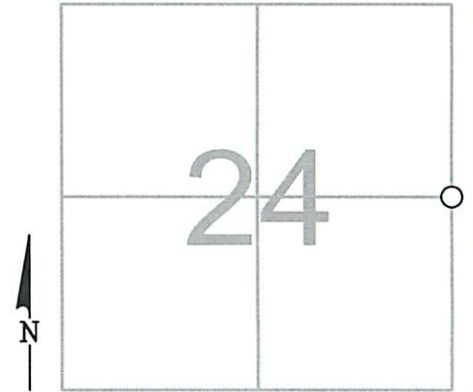

## MONUMENT INFORMATION

MONUMENT TYPE: FD. RAILROAD SPIKE  
ON SURFACE - BELOW: 0.06'  
LEFT - CL PAV'T - RIGHT: 1.15'



## MISC. INFORMATION

RAILROAD SPIKE PER RECORDS ON FILE IN THE OTTAWA COUNTY ENGINEER'S OFFICE. NO RECORD OF STONE SET. TIED RAILROAD SPIKE W/ X-TIES AND DUG TO CONFIRM. NO STONE FOUND. SET 1" SQUARE IRON PIN IN MONUMENT BOX IN PLACE OF RAILROAD SPIKE.

MAY 21, 2012

SET 1" SQUARE IRON PIN  
IN MONUMENT BOX

