

# OTTAWA COUNTY ENGINEERS OFFICE

REFERENCE NO. 24-7-13-1  
 SE CORNER POST SECTION 24  
 CLAY TWP.  
 SHEET 1 OF 1.

ROUTE: C-213 NISSEN RD.

TOWNSHIP: CLAY

SECTION: 24

T 7 NR 13 E.

**PERSONNEL:**

M. WITTMAN, P.S.  
 J. ALLEN  
 C. MILLER  
 E. KOCH


NORTHING:

EASTING:

**DATE / WEATHER / TEMP:**

MAY 19, 2009  
 SUNNY  
 71° F

DATUM:

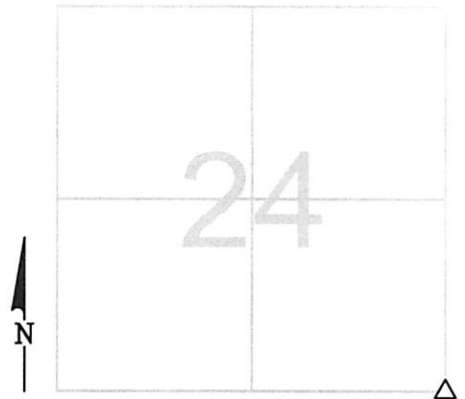

MONUMENT INFORMATION

MONUMENT TYPE: FD HARDHEADS STONE  
 ON SURFACE - BELOW: 1.49'  
LEFT - CL PAV'T - RIGHT: 7.75'  
 EGG-SHAPED STONE: 7" x 5"



MISC. INFORMATION

FD. 5/8" IRON PIN WITH LATHE 0.08' BELOW  
 SURFACE. TIED IRON PIN WITH CROSS TIES,  
 REMOVED AND DUG FOR STONE. USED  
 CENTER OF STONE. 5/8" IRON PIN WAS  
 0.11' NORTH AND 0.03' EAST OF CENTER OF  
 STONE.

MAY 19, 2009

SET 1" SQUARE IRON PIN  
 IN MONUMENT BOX OVER  
 STONE

