

OTTAWA COUNTY ENGINEERS OFFICE

REFERENCE NO. 25-7-13-C
NE CORNER POST SECTION 25
CLAY TWP.
SHEET 1 OF 1.

ROUTE: C-213 NISSEN RD.

TOWNSHIP: CLAY

SECTION: 25

T 7 N R 13 E.

PERSONNEL:

M. WITTMAN, P.S.
J. ALLEN
C. MILLER
E. KOCH


NORTHING:

EASTING:

DATE / WEATHER / TEMP:

MAY 19, 2009
SUNNY
71° F

DATUM:

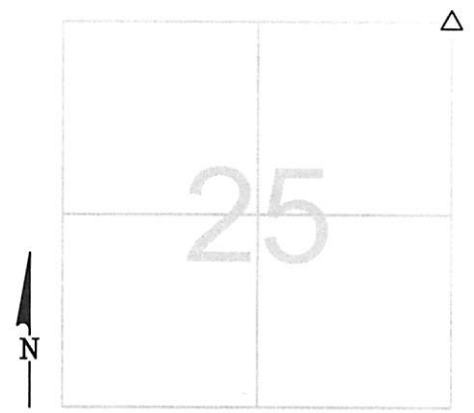

MONUMENT INFORMATION

MONUMENT TYPE: FD HARDHEADS STONE
ON SURFACE - BELOW: 1.49'
LEFT - CL PAV'T - RIGHT: 7.75'
EGG-SHAPED STONE: 7" x 5"



MISC. INFORMATION

FD. 5/8" IRON PIN WITH LATHE 0.08' BELOW SURFACE. TIED IRON PIN WITH CROSS TIES, REMOVED AND DUG FOR STONE. USED CENTER OF STONE. 5/8" IRON PIN WAS 0.11' NORTH AND 0.03' EAST OF CENTER OF STONE.

MAY 19, 2009

SET 1" SQUARE IRON PIN
IN MONUMENT BOX OVER
STONE

