

# OTTAWA COUNTY ENGINEERS OFFICE

REFERENCE NO. 25-7-13-D  
 WEST QUARTER POST SEC. 25  
 CLAY TWP.  
 SHEET 1 OF 1.

ROUTE: T-214 OPFER-LENTZ RD.  
 @ T-82 ZWICKER RD. (ABANDONED)

TOWNSHIP: CLAY


SECTION: 25

T 7 NR 13 E.

NORTHING:

EASTING:

DATUM:

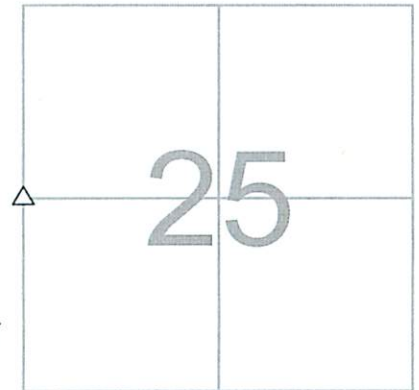

PERSONNEL:  
 M. WITTMAN, P.S.  
 J. ALLEN

DATE / WEATHER / TEMP:  
 JULY 1, 2016  
 OVERCAST - NW  
 72° F

### MONUMENT INFORMATION

MONUMENT TYPE: FD HARDHEAD STONE  
 ON SURFACE - BELOW: 1.30'  
LEFT - CL PAV'T - RIGHT: 4.50'  
  
 12" x 7" TRIANGULAR STONE WITH DRILL HOLE.  
  
 USED DRILL HOLE.



### MISC. INFORMATION

FD RR SPIKE 0.24' BELOW SURFACE, TIED W/  
 X-TIES AND DUG FOR STONE. FD 3/4" SQUARE  
 WOODEN STAKE ON SOUTH EDGE OF STONE. RR  
 SPIKE WAS ONLINE NORTH AND SOUTH AND 0.08'  
 WEST OF DRILL HOLE IN STONE.

JULY 1, 2016

SET 1" SQUARE IRON PIN  
 IN MONUMENT BOX OVER  
 STONE

