

OTTAWA COUNTY ENGINEERS OFFICE

REFERENCE NO. 25-7-13-E

INTERIOR CORNER POST SEC. 25
CLAY TWP.

SHEET 1 OF 1.

PERSONNEL:

M. WITTMAN, P.S.
J. ALLEN
K. BECK

DATE / WEATHER / TEMP:

JULY 22, 2010
SUNNY
85° F

ROUTE: T-85 ZWICKER RD.

TOWNSHIP: CLAY

SECTION: 25

T 7 NR 13 E.

NORTHING:

EASTING:

DATUM:



MONUMENT INFORMATION

MONUMENT TYPE: FD. 10-1/2"x8-1/2" TRIANGULAR
STONE WITH CHISLED "X"
ON SURFACE - BELOW: 0.85'
LEFT - CL PAV'T - RIGHT: 1.60'

USED CHISLED "X"



MISC. INFORMATION


FD. MAG SPIKE ON SURFACE W/ TIES. 1.86' S, 1.71'
N, 2.06' W, 1.91' E. MAG SPIKE WAS 0.13' E AND 0.19'
S OF THE "X" IN THE STONE. THERE WAS ALSO A
1" SQ. IRON PIN ON SOUTH SIDE OF STONE.

JULY 22, 2010

SET 1" SQUARE IRON PIN
IN MONUMENT BOX OVER
STONE

FD. MAG
NAIL SE FACE
AT GROUND

ZWICKER RD., T.R. #82

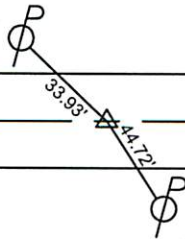

FD. PK
NAIL