

OTTAWA COUNTY ENGINEERS OFFICE

REFERENCE NO. 26-7-13-A
 NW CORNER POST SEC. 26
 CLAY TWP.
SHEET 1 OF 1.


PERSONNEL:
 M. WITTMAN, P.S.
 J. ALLEN

DATE / WEATHER / TEMP:
 DECEMBER 3, 2009
 OVERCAST - W
 41° F

ROUTE: T-65 HELLWIG RD.
 @ C-7 MARTIN - WILLISTON RD.

TOWNSHIP: CLAY
SECTION: 26
 T 7 N R 13 E.

NORTHING:
EASTING:
DATUM:

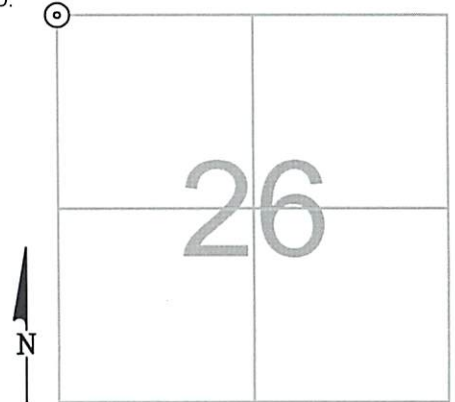

MONUMENT INFORMATION

MONUMENT TYPE: FD. 3/8" IRON BOLT IN CONC.
 ON SURFACE - BELOW: 0.73'
LEFT - CL PAV'T - RIGHT: 6.50'



MISC. INFORMATION

BOLT (PIN) IN CONCRETE PER COUNTY RECORDS
 WPA BOOK 1 PAGE 77

DECEMBER 3, 2009

SET MONUMENT BOX OVER
 BOLT IN CONCRETE

