

# OTTAWA COUNTY ENGINEERS OFFICE

REFERENCE NO. 27-7-13-G  
SW CORNER SEC. 27  
CLAY TWP.

SHEET 1 OF 1.

**PERSONNEL:**

J. ALLEN  
M. ULLRICH  
S. ULLRICH

**DATE / WEATHER / TEMP:**

AUGUST 29, 2008  
CLOUDY  
71° F

ROUTE: MAINST. @ SEVENTEENTH ST.  
(IN VILLAGE OF GENOA)

TOWNSHIP: CLAY


SECTION: 27

T 7 NR 13 E.

NORTHING:

EASTING:

DATUM:

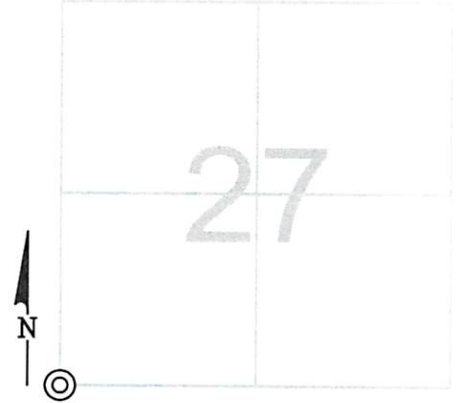

MONUMENT INFORMATION

MONUMENT TYPE: FD 1" Ø IRON PIN IN  
CONCRETE W/ PUNCH MARK  
ON SURFACE - BELOW:  
LEFT - CL PAVT - RIGHT:



MISC. INFORMATION

