


OTTAWA COUNTY ENGINEERS OFFICE

REFERENCE NO. 28-7-13-B
 NORTH QUARTER POST SEC. 28
 CLAY TWP.
SHEET 1 OF 1.

ROUTE: T-65 HELLWIG RD.
TOWNSHIP: CLAY
SECTION: 28
T 7 **NR** 13 **E.**

PERSONNEL:
 M. WITTMAN, P.S.
 J. ALLEN

NORTHING:
EASTING:
DATUM:

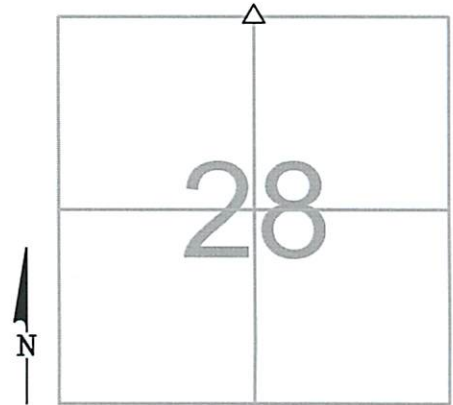

DATE / WEATHER / TEMP:
 NOVEMBER 5, 2009
 SUNNY - W-NW
 45° F

MONUMENT INFORMATION

MONUMENT TYPE: FD. 3-1/2"x5" TRIANGULAR STONE WITH DRILL HOLE
 ON SURFACE - BELOW: 1.00'
 LEFT - CL PAV'T - RIGHT: 5.85'

 USED DRILL HOLE



MISC. INFORMATION

FD. 1" Ø IRON PIPE AT SURFACE. TIED WITH X-TIES AND DUG FOR STONE. IRON PIPE WAS DRIVEN ON WEST SIDE OF STONE AND BENT OVER THE CENTER OF STONE. TOP OF PIPE WAS 0.09'W AND 0.09' N OF THE DRILL HOLE. PULLED PIPE AND SET 1" SQ. IRON PIN IN MONUMENT BOX.

NOVEMBER 5, 2009

SET 1" SQUARE IRON PIN
 IN MONUMENT BOX OVER
 STONE

