

OTTAWA COUNTY ENGINEERS OFFICE

REFERENCE NO. 28-7-13-C
NE CORNER SECTION 28
CLAY TWP.
SHEET 1 OF 1.

PERSONNEL:
M. WITTMAN, P.S.
J. ALLEN

DATE / WEATHER / TEMP:
OCTOBER 16, 2008
OVERCAST N
57° F

ROUTE: C-23 GENOA-CLAY CENTER RD.
@ T-65 HELLWIG RD.

TOWNSHIP: CLAY


SECTION: 28

T 7 N R 13 E.

NORTHING:

EASTING:

DATUM:

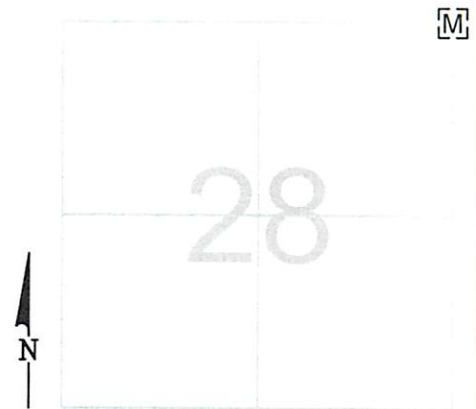

MONUMENT INFORMATION

MONUMENT TYPE: FD. 1" SQUARE IRON PIN W/
DRILL HOLE
ON SURFACE - BELOW: 0.63'
LEFT - CL PAV'T - RIGHT: 0.65'



MISC. INFORMATION

