

# OTTAWA COUNTY ENGINEERS OFFICE

REFERENCE NO. 28-7-13-G  
 SW CORNER POST SEC. 28  
 CLAY TWP.  
 SHEET 1 OF 1.

ROUTE: T-64 HOLT-HARRIGAN RD.  
 @ T- 53 REIMAN RD.

TOWNSHIP: CLAY

SECTION: 28

T 7 NR 13 E.

PERSONNEL:  
 M. WITTMAN, P.S.  
 J. ALLEN  
 J. TIMMONS


NORTHING:

EASTING:

DATE / WEATHER / TEMP:

JULY 11, 2016  
 SUNNY - S-SW  
 86° F - HUMID

DATUM:

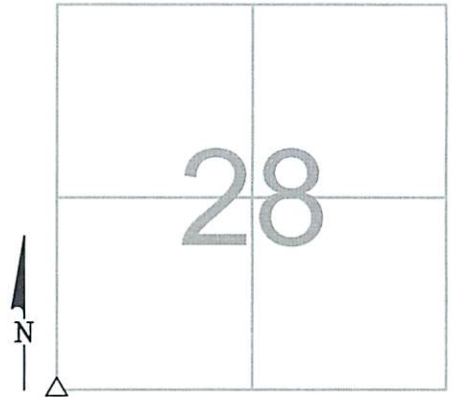

### MONUMENT INFORMATION

MONUMENT TYPE: FD 6" x 6" x 8" SANDSTONE  
 ON SURFACE - BELOW: 2.16'  
 LEFT - CL PAV'T - RIGHT: 3.5' (HOLT-HARRIGAN RD.)  
LEFT - CL PAV'T - RIGHT: 3.0' (REIMAN RD.)

SQUARETOP SANDSTONE. USED CENTER OF STONE.



### MISC. INFORMATION

FD MAG NAIL ON SURFACE, TIED W/ X-TIES AND  
 DUG FOR STONE. SURFACE PK NAIL WAS OVER  
 CENTER OF STONE.

JULY 11, 2016

SET 1" SQUARE IRON PIN  
 IN MONUMENT BOX OVER  
 STONE

