

# OTTAWA COUNTY ENGINEERS OFFICE

REFERENCE NO. 28-7-13-H  
SOUTH QUARTER POST SEC. 28  
CLAY TWP.  
SHEET 1 OF 1.

ROUTE: T-64 HOLT-HARRIGAN RD.

TOWNSHIP: CLAY

SECTION: 28

T 7 NR 13 E.

NORTHING:

EASTING:


DATUM:

**PERSONNEL:**

M. WITTMAN, P.S.  
J. ALLEN  
J. TIMMONS

**DATE / WEATHER / TEMP:**

JULY 12, 2016  
SUNNY - S  
83° F - HUMID

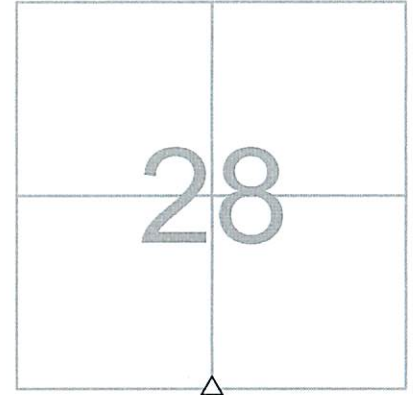

MONUMENT INFORMATION

MONUMENT TYPE: FD 10" x 10" LIMESTONE  
ON SURFACE - BELOW: 0.82'  
LEFT - CL PAV'T - RIGHT: 2.90'

USED DRILL HOLE IN STONE.



MISC. INFORMATION

FD RR SPIKE 0.25' BELOW SURFACE, TIED W/  
X-TIES AND DUG FOR STONE. STONE WAS  
SURROUNDED BY LARGE ACCESSORY STONES.  
RR SPIKE WAS DIRECTLY OVER DRILL HOLE FD.  
ENHANCED DRILL HOLE IN STONE.

JULY 12, 2016

SET MONUMENT BOX OVER  
STONE

