

OTTAWA COUNTY ENGINEERS OFFICE

REFERENCE NO. 28-7-13-I
SE CORNER SEC. 28
CLAY TWP.

ROUTE: MAINST. @ SEVENTEENTH ST.
(IN VILLAGE OF GENOA)

SHEET 1 OF 1.

TOWNSHIP: CLAY

PERSONNEL:

J. ALLEN
M. ULLRICH
S. ULLRICH

SECTION: 28

T 7 NR 13 E.


NORTHING:

EASTING:

DATE / WEATHER / TEMP:

AUGUST 29, 2008
CLOUDY
71° F

DATUM:

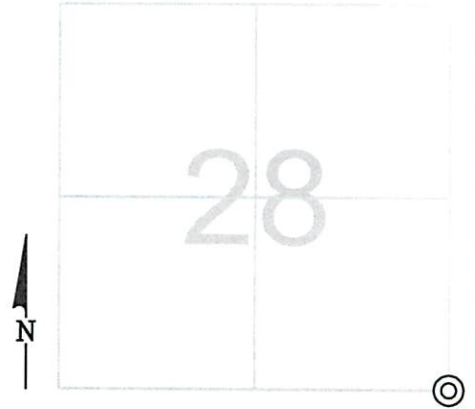

MONUMENT INFORMATION

MONUMENT TYPE: FD 1" Ø IRON PIN IN
CONCRETE W/ PUNCH MARK
ON SURFACE - BELOW:
LEFT - CL PAVT - RIGHT:



MISC. INFORMATION

