

# OTTAWA COUNTY ENGINEERS OFFICE

REFERENCE NO. 29-7-13-B  
NORTH QUARTER POST SEC. 29  
CLAY TWP.  
SHEET 1 OF 1.

PERSONNEL:  
M. WITTMAN, P.S.  
J. ALLEN

DATE / WEATHER / TEMP:  
NOVEMBER 3, 2009  
SUNNY - SW  
47° F

ROUTE: T-65 HELLWIG RD.

TOWNSHIP: CLAY


SECTION: 29

T 7 N R 13 E.

NORTHING:

EASTING:

DATUM:

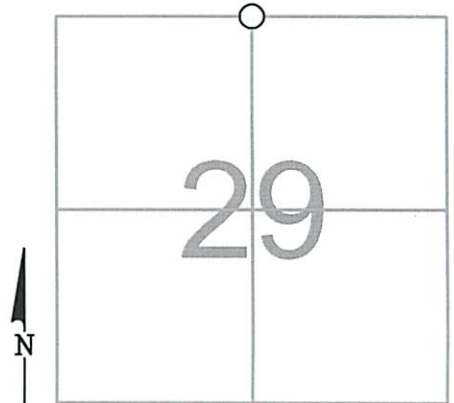


## MONUMENT INFORMATION

MONUMENT TYPE: FD. 1" SQ. IRON PIN  
ON SURFACE - BELOW: 0.05'  
LEFT - CL PAV'T - RIGHT: 4.10'

## MISC. INFORMATION

DROVE PIN STRAIGHT DOWN 4" TO FIT MONUMENT  
BOX OVER

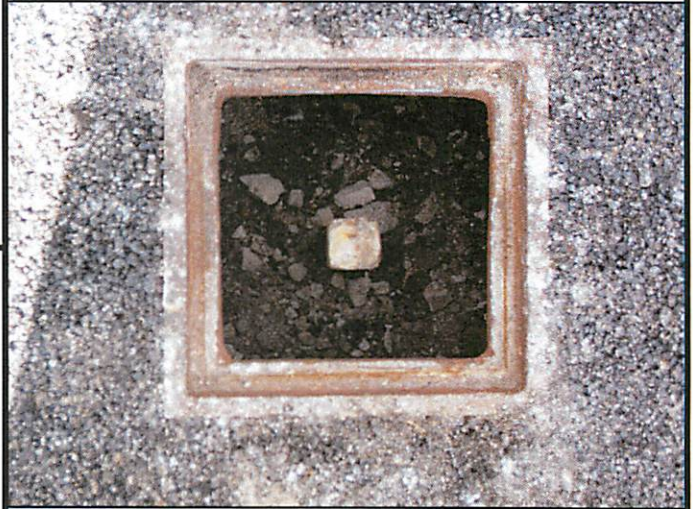

NOVEMBER 2, 2009

SET MONUMENT BOX OVER  
1" SQ. IRON PIN

