

OTTAWA COUNTY ENGINEERS OFFICE

REFERENCE NO. 29-7-13-D
 WEST QUARTER POST SEC. 29
 CLAY TWP.

SHEET 1 OF 1.

PERSONNEL:
 M. WITTMAN, P.S.
 J. ALLEN

DATE / WEATHER / TEMP:
 NOVEMBER 2, 2009
 OVERCAST
 45° F

ROUTE: T-54 BILLMAN RD.

TOWNSHIP: CLAY


SECTION: 29

T 7 **NR** 13 **E.**

NORTHING:

EASTING:

DATUM:

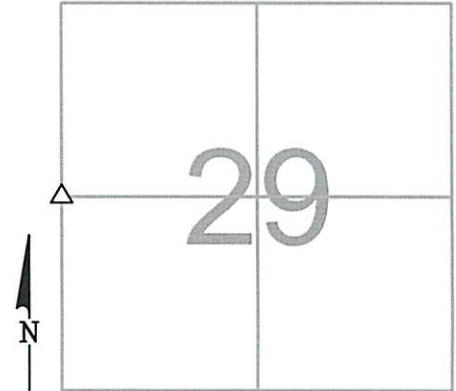

MONUMENT INFORMATION

MONUMENT TYPE: FD. 4"x6"x10" POINTED LIMESTONE WITH "X" ON HIGH POINT ON SURFACE - BELOW: 1.13
 LEFT - CL PAV'T - RIGHT: 1.75'

USED CHISLED "X"



MISC. INFORMATION

FD. 1" SQ. TOP BOLT 0.27' BELOW SURFACE. TIED WITH X-TIES AND DUG FOR STONE. DID NOT FIND STONE UNDER BOLT. SHOT DISTANCE N AND S AND RE-DUG 3 FEET SOUTH OF BOLT AND FOUND STONE. "X" IN STONE WAS 3' SOUTH OF BOLT. THE BOLT APPEARS TO BE A TIE POINT.

NOVEMBER 2, 2009

SET 1" SQUARE IRON PIN IN MONUMENT BOX OVER STONE

SET 5/8" IRON PIN w/ OCE CAP FOR REF. TIE 2' W. OF EOP

SET 5/8" IRON PIN w/ OCE CAP FOR REF. TIE 2' W. OF EOP

