

OTTAWA COUNTY ENGINEERS OFFICE

REFERENCE NO. 3-6-13-C
 NE CORNER POST SEC. 3
 CLAY TWP.
SHEET 1 OF 1.

ROUTE: STATE ROUTE #163
 @ T-7 MARTIN WILLISTON RD.

TOWNSHIP: CLAY

SECTION: 3

T 6 **NR** 13 **E.**


PERSONNEL:

M. WITTMAN, P.S.
 J. ALLEN
 R. NUHGER, P.S. - ODOT
 S. CODER, PS. - ODOT
 J. RHODES - ODOT

NORTHING:

EASTING:

DATUM:

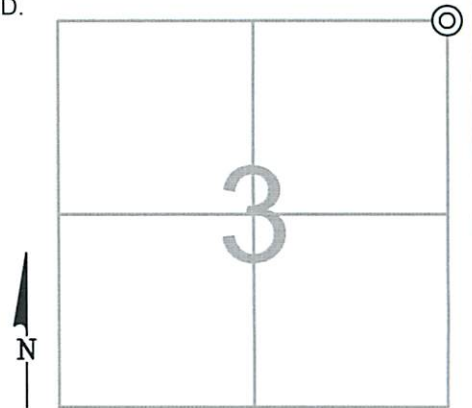

DATE / WEATHER / TEMP:

APRIL 29, 2013
 OVERCAST
 59° F

MONUMENT INFORMATION

MONUMENT TYPE: FD. 1" SQ HEAD BOLT IN CONC.
 ON SURFACE - BELOW: 0.76'
 LEFT - CL PAV'T - RIGHT: 1.82' (SR 163) 1.3' L (C/L T-7)

6" Ø CONCRETE MONUMENT

USED CENTER OF SQUARE HEAD OF BOLT



MISC. INFORMATION

FD ODOT NAIL AND SHINER ON SURFACE, TIED W-
 X-TIES AND DUG FOR BRICK NOTED ON RECORD -
 FD BOLT IN CONCRETE

NAIL ON SURFACE WAS 0.21' S AND 0.05' E OF
 CENTER OF HEAD OF BOLT.

SEPTEMBER 9, 2013

SET MONUMENT BOX OVER
 CONCRETE MONUMENT
 (ODOT ASSISTANCE)

