

# OTTAWA COUNTY ENGINEERS OFFICE

**REFERENCE NO.** 30-7-13-F  
 EAST QUARTER POST SEC. 30  
 CLAY TWP.  
**SHEET** 1 **OF** 1.

**ROUTE:** T-54 BILLMAN RD.

**TOWNSHIP:** CLAY

**SECTION:** 30


**T** 7 **N**R 13 **E.**

**PERSONNEL:**  
 M. WITTMAN, P.S.  
 J. ALLEN

**NORTHING:**

**EASTING:**

**DATUM:**

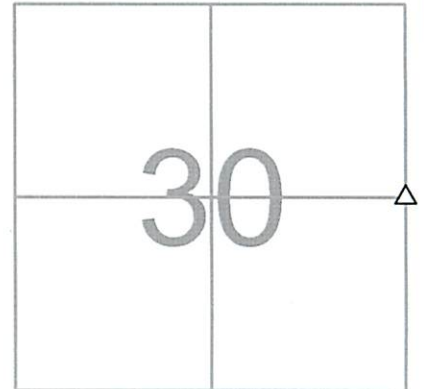

**DATE / WEATHER / TEMP:**  
 NOVEMBER 2, 2009  
 OVERCAST  
 45° F

### MONUMENT INFORMATION

MONUMENT TYPE: FD. 4"x6"x10" POINTED LIMESTONE WITH "X" ON HIGH POINT ON SURFACE - BELOW: 1.13  
 LEFT - CL PAV'T - RIGHT: 1.75'

USED CHISLED "X"



### MISC. INFORMATION

FD. 1" SQ. TOP BOLT 0.27' BELOW SURFACE. TIED WITH X-TIES AND DUG FOR STONE. DID NOT FIND STONE UNDER BOLT. SHOT DISTANCE N AND S AND RE-DUG 3 FEET SOUTH OF BOLT AND FOUND STONE. "X" IN STONE WAS 3' SOUTH OF BOLT. THE BOLT APPEARS TO BE A TIE POINT.

NOVEMBER 2, 2009

SET 1" SQUARE IRON PIN IN MONUMENT BOX OVER STONE

SET 5/8" IRON PIN w/ OCE CAP FOR REF. TIE 2' W. OF EOP

SET 5/8" IRON PIN w/ OCE CAP FOR REF. TIE 2' W. OF EOP

