

# OTTAWA COUNTY ENGINEERS OFFICE

REFERENCE NO. 30-7-13-G  
 SW CORNER POST SEC. 30  
 CLAY TWP.  
 SHEET 1 OF 1.

ROUTE: C-2 FOSTORIA RD.  
 @ T-64 HOLT-HARRIGAN RD.

TOWNSHIP: CLAY

SECTION: 30


T 7 NR 13 E.

PERSONNEL:  
 M. WITTMAN, P.S.  
 J. ALLEN  
 J. TIMMONS

NORTHING:

EASTING:

DATUM:

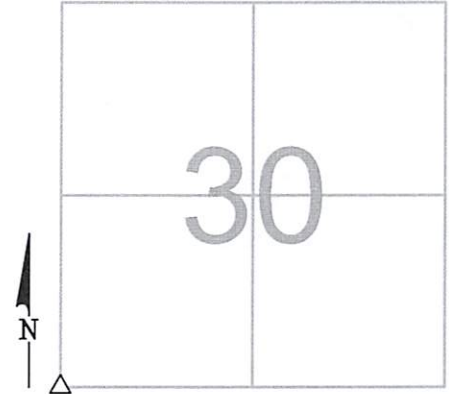

DATE / WEATHER / TEMP:  
 JULY 8, 2016  
 OVERCAST - W-NW  
 79° F - HUMID

### MONUMENT INFORMATION

MONUMENT TYPE: FD 8" x 10" LIMESTONE  
 ON SURFACE - BELOW: 1.24'  
 LEFT - CL PAV'T - RIGHT: 4.30' (FOSTORIA RD.)  
 LEFT - CL PAV'T - RIGHT: 1.30' (HOLT-HARRIGAN RD.)

RECTANGULAR SHAPED LIMESTONE, STONE WAS  
 BROKEN ON WEST EDGE. USED CENTER OF STONE.



### MISC. INFORMATION

FD HARROW TOOTH ON SURFACE, TIED W/ X-TIES  
 AND DUG FOR STONE. HARROW TOOTH WAS OVER  
 CENTER OF STONE. IRON PIN IS 1.34' WEST OF  
 COUNTY LINE.

THIS IS A CLOSING CORNER.

JULY 8, 2016

SET 1" SQUARE IRON PIN  
 IN MONUMENT BOX OVER  
 STONE

