

OTTAWA COUNTY ENGINEERS OFFICE

REFERENCE NO. 30-7-13-1
SE CORNER POST SEC. 30
CLAY TWP.
SHEET 1 OF 1.

PERSONNEL:
M. WITTMAN, P.S.
J. ALLEN

DATE / WEATHER / TEMP:
OCTOBER 8, 2009
OVERCAST - SW
56° F

ROUTE: T-54 BILLMAN RD.
@ T-64 HOLT HARRIGAN RD.

TOWNSHIP: CLAY


SECTION: 30

T 7 NR 13 E.

NORTHING:

EASTING:

DATUM:

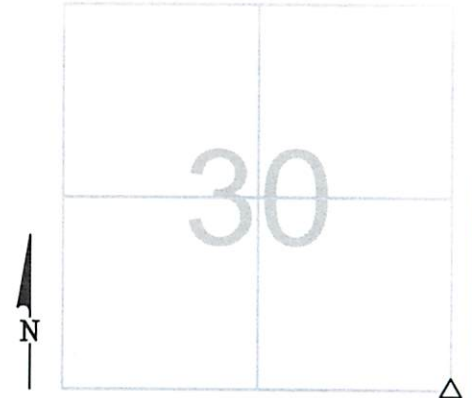

MONUMENT INFORMATION

MONUMENT TYPE: FD. POINTED LIMESTONE
ON SURFACE - BELOW: 1.30'
LEFT - CL PAV'T - RIGHT: 2.35'

RECTANGULAR STONE: 3" x 4" (TOP)
(STONE WIDENS TO 6" BELOW SURFACE)



MISC. INFORMATION

FD SPRING OVER STONE.

OCTOBER 8, 2009

SET 1" SQUARE IRON PIN
IN MONUMENT BOX OVER
STONE

