

OTTAWA COUNTY ENGINEERS OFFICE

REFERENCE NO. 31-7-13-A
 NW CORNER POST SEC. 31
 CLAY TWP.
 SHEET 1 OF 1.

ROUTE: C-2 FOSTORIA RD.
 @ T-64 HOLT-HARRIGAN RD.

TOWNSHIP: CLAY

SECTION: 31


T 7 N R 13 E.

PERSONNEL:
 M. WITTMAN, P.S.
 J. ALLEN
 J. TIMMONS

NORTHING:

EASTING:

DATUM:

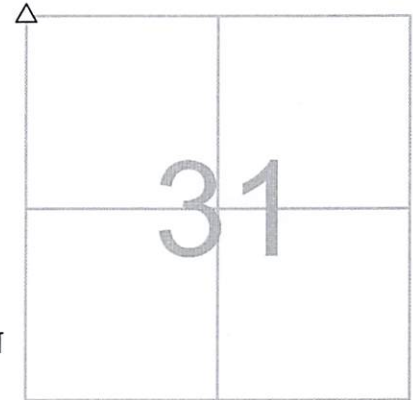

DATE / WEATHER / TEMP:
 JULY 8, 2016
 OVERCAST - W-NW
 79° F - HUMID

MONUMENT INFORMATION

MONUMENT TYPE: FD 8" x 10" LIMESTONE
 ON SURFACE - BELOW: 1.24'
LEFT - CL PAV'T - RIGHT: 4.30' (FOSTORIA RD.)
LEFT - CL PAV'T - RIGHT: 1.30' (HOLT-HARRIGAN RD.)

RECTANGULAR SHAPED LIMESTONE, STONE WAS
 BROKEN ON WEST EDGE. USED CENTER OF STONE.



MISC. INFORMATION

FD HARROW TOOTH ON SURFACE, TIED W/ X-TIES
 AND DUG FOR STONE. HARROW TOOTH WAS OVER
 CENTER OF STONE. IRON PIN IS 1.34' WEST OF
 COUNTY LINE.

THIS IS A CLOSING CORNER.

JULY 8, 2016

SET 1" SQUARE IRON PIN
 IN MONUMENT BOX OVER
 STONE

