


# OTTAWA COUNTY ENGINEERS OFFICE

REFERENCE NO. 31-7-13-D  
 WEST QUARTER POST SEC. 31  
 CLAY TWP.  
 SHEET 1 OF 1.

ROUTE: C-2 FOSTORIA RD.  
 TOWNSHIP: CLAY  
 SECTION: 31  
 T 7 NR 13 E.

PERSONNEL:  
 M. WITTMAN, P.S.  
 J. ALLEN  
 B. BRADY  
 M. HEINTZ  
 A. STAIB - WOOD CO.

NORTHING:  
 EASTING:  
 DATUM:

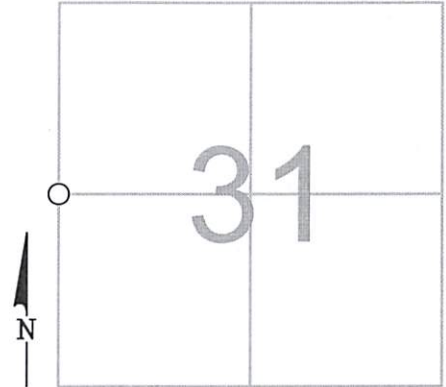

DATE / WEATHER / TEMP:  
 MAY 8, 2024  
 SUNNY W  
 67° F

### MONUMENT INFORMATION

MONUMENT TYPE: FD. RAILROAD SPIKE  
 ON SURFACE - BELOW: 0.45'  
LEFT - CL PAV'T - RIGHT: 9'  
  
 NO STONE ON RECORD, FD. RAILROAD SPIKE PER  
 VARIOUS SURVEYS OF RECORD



### MISC. INFORMATION

FD. RR SPIKE AT CALCULATED POINT FROM  
 SURVEYS ON RECORD. DUG 2' X 2' HOLE 15"  
 DOWN TO CLAY AND PRODDED ADD. 2' DOWN ON  
 A 5" GRID, DID NOT FIND A STONE. SET 1" SQ. IRON  
 PIN IN MONUMENT BOX IN PLACE OF RAILROAD  
 SPIKE. PIN IS 0.47' WEST OF COUNTY LINE.  
THIS IS A CLOSING CORNER

MAY 8, 2024

SET 1" SQUARE IRON PIN  
 IN MONUMENT BOX IN  
 PLACE OF RR SPIKE

