

OTTAWA COUNTY ENGINEERS OFFICE

REFERENCE NO. 31-7-13-F
 EAST QUARTER POST SEC. 31
 CLAY TWP.
SHEET 1 OF 1.

ROUTE: T-54 BILLMAN RD.

TOWNSHIP: CLAY

SECTION: 31


T 7 **NR** 13 **E.**

PERSONNEL:
 M. WITTMAN, P.S.
 J. ALLEN

NORTHING:

EASTING:

DATUM:

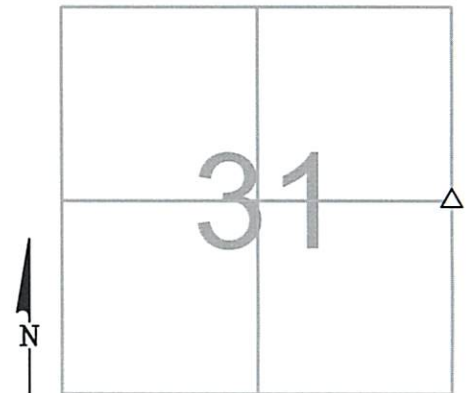

DATE / WEATHER / TEMP:
 NOVEMBER 3, 2009
 SUNNY - NW
 41° F

MONUMENT INFORMATION

MONUMENT TYPE: FD. 4"x10" LIMESTONE
 ON SURFACE - BELOW: 1.08'
LEFT - CL PAV'T - RIGHT: 3.90'
 USED CENTER OF STONE



MISC. INFORMATION

NOVEMBER 3, 2009

SET 1" SQUARE IRON PIN
 IN MONUMENT BOX OVER
 STONE

