

OTTAWA COUNTY ENGINEERS OFFICE

REFERENCE NO. 32-7-13-B
NORTH QUARTER POST SEC. 32
CLAY TWP.
SHEET 1 OF 1.

ROUTE: T-64 HOLT-HARRIGAN RD.

TOWNSHIP: CLAY

SECTION: 32

T 7 N R 13 E.


PERSONNEL:
M. WITTMAN, P.S.
J. ALLEN
J. TIMMONS

NORTHING:

EASTING:

DATE / WEATHER / TEMP:
JULY 11, 2016
PTLY SUNNY - S-SW
75° F

DATUM:

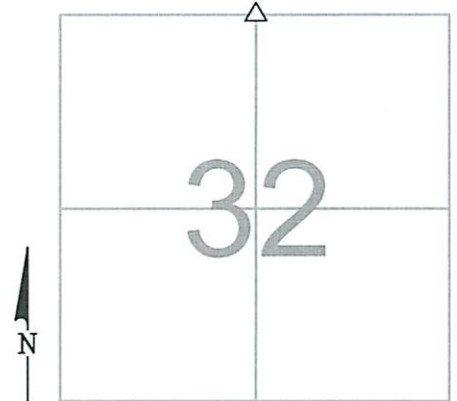

MONUMENT INFORMATION

MONUMENT TYPE: FD HARDHEAD STONE
ON SURFACE - BELOW: 1.44'
LEFT - CL PAV'T - RIGHT: 2.00'

8" x 14 FOOTBALL SHAPED STONE. USED CENTER
OF HIGH RIDGE OF STONE.



MISC. INFORMATION

FD RR SPIKE 0.32' BELOW SURFACE, TIED W/
X-TIES AND DUG FOR STONE. RR SPIKE WAS 0.13'
SOUTH AND 0.01' WEST OF POINT USED ON STONE.

JULY 11, 2016

SET 1" SQUARE IRON PIN
IN MONUMENT BOX OVER
STONE

