

OTTAWA COUNTY ENGINEERS OFFICE

REFERENCE NO. 32-7-13-C
 NE CORNER POST SEC. 32
 CLAY TWP.
 SHEET 1 OF 1.

PERSONNEL:
 M. WITTMAN, P.S.
 J. ALLEN
 J. TIMMONS

DATE / WEATHER / TEMP:
 JULY 11, 2016
 SUNNY - S-SW
 86° F - HUMID

ROUTE: T-64 HOLT-HARRIGAN RD.
 @ T- 53 REIMAN RD.

TOWNSHIP: CLAY


SECTION: 32

T 7 NR 13 E.

NORTHING:

EASTING:

DATUM:

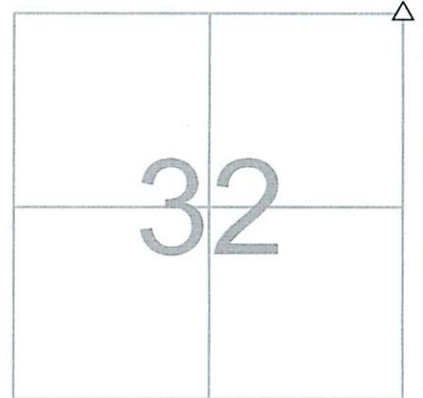

MONUMENT INFORMATION

MONUMENT TYPE: FD 6" x 6" x 8" SANDSTONE
 ON SURFACE - BELOW: 2.16'
 LEFT - CL PAV'T - RIGHT: 3.5' (HOLT-HARRIGAN RD.)
LEFT - CL PAV'T - RIGHT: 3.0' (REIMAN RD.)

SQUARETOP SANDSTONE. USED CENTER OF STONE.



MISC. INFORMATION

FD MAG NAIL ON SURFACE, TIED W/ X-TIES AND
 DUG FOR STONE. SURFACE PK NAIL WAS OVER
 CENTER OF STONE.

JULY 11, 2016

SET 1" SQUARE IRON PIN
 IN MONUMENT BOX OVER
 STONE

