

OTTAWA COUNTY ENGINEERS OFFICE

REFERENCE NO. 32-7-13-D
WEST QUARTER POST SEC. 32
CLAY TWP.
SHEET 1 OF 1.

ROUTE: T-54 BILLMAN RD.

TOWNSHIP: CLAY

SECTION: 32


T 7 NR 13 E.

PERSONNEL:
M. WITTMAN, P.S.
J. ALLEN

NORTHING:

EASTING:

DATUM:

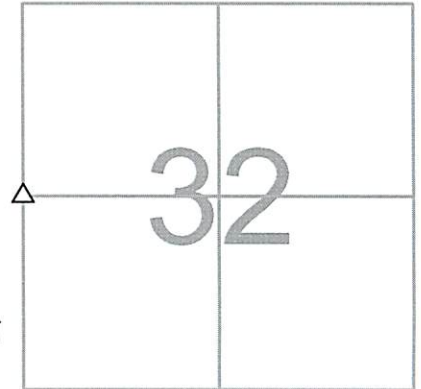

DATE / WEATHER / TEMP:
NOVEMBER 3, 2009
SUNNY - NW
41° F

MONUMENT INFORMATION

MONUMENT TYPE: FD. 4"x10" LIMESTONE
ON SURFACE - BELOW: 1.08'
LEFT - CL PAV'T - RIGHT: 3.90'

USED CENTER OF STONE



MISC. INFORMATION

NOVEMBER 3, 2009

SET 1" SQUARE IRON PIN
IN MONUMENT BOX OVER
STONE

