

OTTAWA COUNTY ENGINEERS OFFICE

REFERENCE NO. 32-7-13-1
SE CORNER POST SEC. 32
CLAY TWP.
SHEET 1 OF 1.

ROUTE: STATE ROUTE #163
@ REIMAN RD., T-53

TOWNSHIP: CLAY

SECTION: 32

T 7 NR 13 E.


NORTHING:

EASTING:

DATUM:


PERSONNEL:
M. WITTMAN, P.S.
J. ALLEN

DATE / WEATHER / TEMP:
AUGUST 29, 2013
SUNNY
83° F

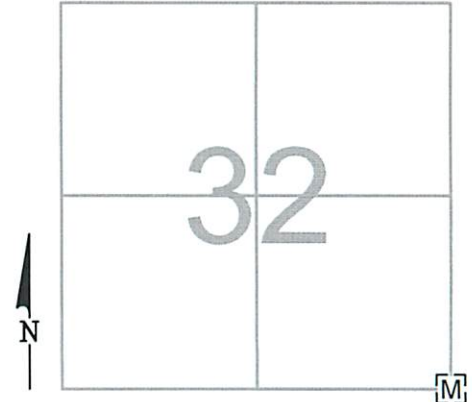

MONUMENT INFORMATION

MONUMENT TYPE: FD. 1" Ø IRON PIN IN MON BOX
ON SURFACE - BELOW:
LEFT - CL PAV'T - RIGHT: 0.4'

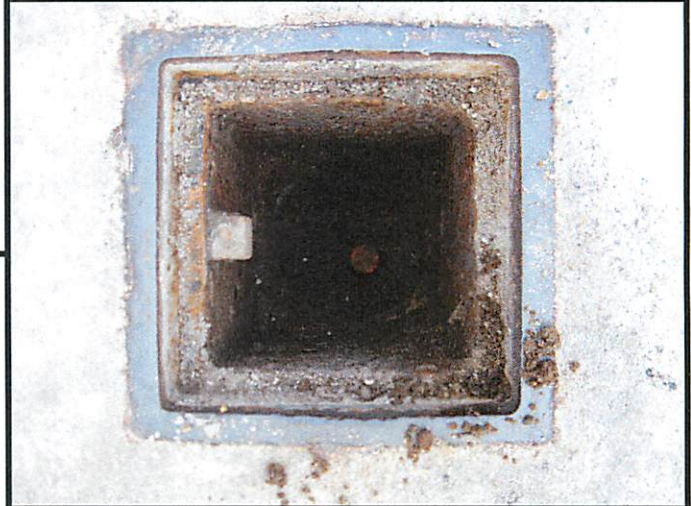

MISC. INFORMATION

