

# OTTAWA COUNTY ENGINEERS OFFICE

REFERENCE NO. 33-7-13-A  
NW CORNER POST SEC. 33  
CLAY TWP.  
SHEET 1 OF 1.

PERSONNEL:  
M. WITTMAN, P.S.  
J. ALLEN  
J. TIMMONS

DATE / WEATHER / TEMP:  
JULY 11, 2016  
SUNNY - S-SW  
86° F - HUMID

ROUTE: T-64 HOLT-HARRIGAN RD.  
@ T-53 REIMAN RD.

TOWNSHIP: CLAY


SECTION: 33

T 7 N R 13 E.

NORTHING:

EASTING:

DATUM:

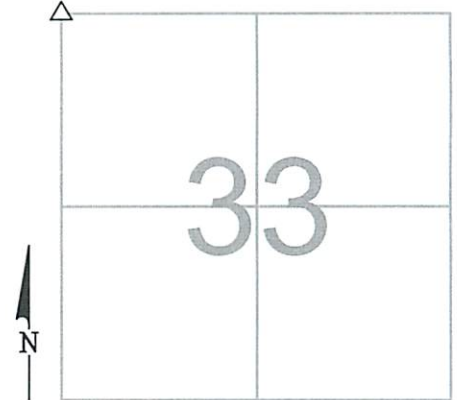

## MONUMENT INFORMATION

MONUMENT TYPE: FD 6" x 6" x 8" SANDSTONE  
ON SURFACE - BELOW: 2.16'  
LEFT - CL PAV'T - RIGHT: 3.5' (HOLT-HARRIGAN RD.)  
LEFT - CL PAV'T - RIGHT: 3.0' (REIMAN RD.)

SQUARETOP SANDSTONE. USED CENTER OF STONE.



## MISC. INFORMATION

FD MAG NAIL ON SURFACE, TIED W/ X-TIES AND  
DUG FOR STONE. SURFACE PK NAIL WAS OVER  
CENTER OF STONE.

JULY 11, 2016

SET 1" SQUARE IRON PIN  
IN MONUMENT BOX OVER  
STONE

