

OTTAWA COUNTY ENGINEERS OFFICE

REFERENCE NO. 33-7-13-B
NORTH QUARTER POST SEC. 33
CLAY TWP.
SHEET 1 OF 1.

ROUTE: T-64 HOLT-HARRIGAN RD.

TOWNSHIP: CLAY

SECTION: 33

T 7 NR 13 E.

PERSONNEL:

M. WITTMAN, P.S.
J. ALLEN
J. TIMMONS


NORTHING:

EASTING:

DATE / WEATHER / TEMP:

JULY 12, 2016
SUNNY - S
83° F - HUMID

DATUM:

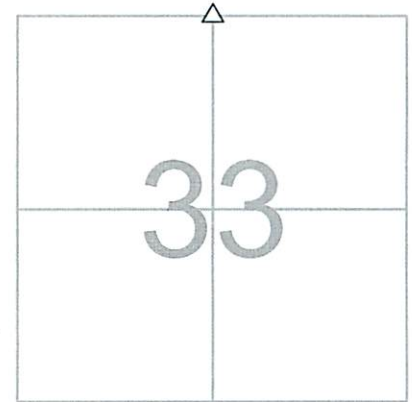

MONUMENT INFORMATION

MONUMENT TYPE: FD 10" x 10" LIMESTONE
ON SURFACE - BELOW: 0.82'
LEFT - CL PAV'T - RIGHT: 2.90'

USED DRILL HOLE IN STONE.



MISC. INFORMATION

FD RR SPIKE 0.25' BELOW SURFACE, TIED W/
X-TIES AND DUG FOR STONE. STONE WAS
SURROUNDED BY LARGE ACCESSORY STONES.
RR SPIKE WAS DIRECTLY OVER DRILL HOLE FD.
ENHANCED DRILL HOLE IN STONE.

JULY 12, 2016

SET MONUMENT BOX OVER
STONE

