

OTTAWA COUNTY ENGINEERS OFFICE

REFERENCE NO. 33-7-13-H
SOUTH QUARTER POST SEC. 33
CLAY TWP.
SHEET 1 OF 1.

ROUTE: STATE ROUTE #163

TOWNSHIP: CLAY

SECTION: 33

T 7 NR 13 E.


PERSONNEL:
M. WITTMAN, P.S.
J. ALLEN

NORTHING:

EASTING:

DATUM:

DATE / WEATHER / TEMP:
AUGUST 29, 2013
SUNNY
83° F

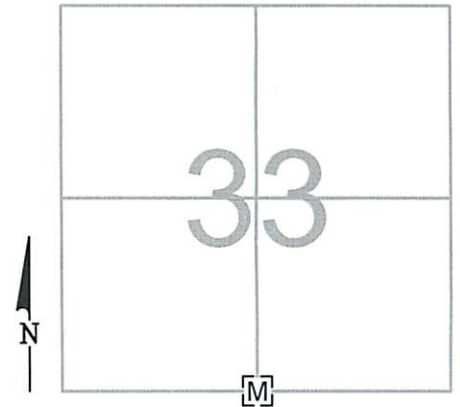

MONUMENT INFORMATION

MONUMENT TYPE: FD. 1" Ø IRON PIN IN MON BOX
ON SURFACE - BELOW:
LEFT - CL PAV'T - RIGHT:



MISC. INFORMATION

