

OTTAWA COUNTY ENGINEERS OFFICE

REFERENCE NO. 34-7-13-A
NW CORNER SEC. 34
CLAY TWP.

SHEET 1 OF 1.

PERSONNEL:

J. ALLEN
M. ULLRICH
S. ULLRICH

DATE / WEATHER / TEMP:

AUGUST 29, 2008
CLOUDY
71° F

ROUTE: MAINST. @ SEVENTEENTH ST.
(IN VILLAGE OF GENOA) ©

TOWNSHIP: CLAY


SECTION: 34

T 7 NR 13 E.

NORTHING:

EASTING:

DATUM:

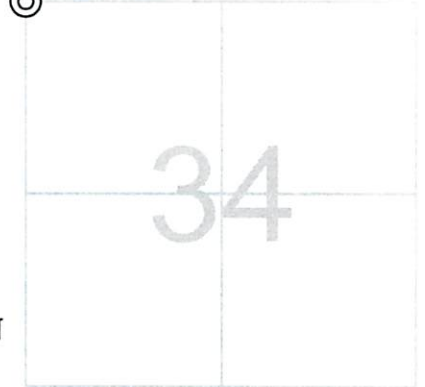

MONUMENT INFORMATION

MONUMENT TYPE: FD 1" Ø IRON PIN IN
CONCRETE W/ PUNCH MARK
ON SURFACE - BELOW:
LEFT - CL PAVT - RIGHT:



MISC. INFORMATION

