

OTTAWA COUNTY ENGINEERS OFFICE

REFERENCE NO. 34-7-13-H
 SOUTH QUARTER POST SEC. 34
 CLAY TWP.
 SHEET 1 OF 1.

ROUTE: STATE ROUTE #163

TOWNSHIP: CLAY

SECTION: 34

T 7 NR 13 E.

PERSONNEL:

M. WITTMAN, P.S.
 J. ALLEN
 J. O'DONNELL, P.S. - ODOT
 D. TODD - ODOT
 J. RHOADES - ODOT


NORTHING:

EASTING:

DATE / WEATHER / TEMP:

NOVEMBER 22, 2016
 SUNNY
 30° F

DATUM:

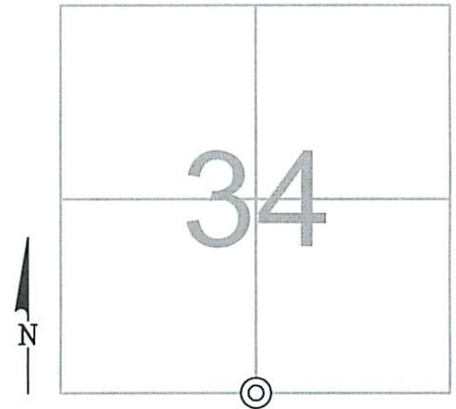

MONUMENT INFORMATION

MONUMENT TYPE: 1" Ø IRON PIN IN 2" Ø IRON PIPE
 ON SURFACE - BELOW: 0.78'
 LEFT - CL PAV'T - RIGHT:

IRON PIPE WAS IN HARD CONCRETE LIKE SURFACE.



MISC. INFORMATION

FD PK NAIL AND SHINER ON SURFACE, TIED WITH GPS AND DUG FOR STONE. FOUND RR SPIKE 0.24' BELOW SURFACE 0.07' SOUTH AND 0.07' EAST OF SURFACE NAIL. FOUND IRON PIN IN PIPE 0.78' BELOW SURFACE 0.06' SOUTH AND 0.03' EAST OF SURFACE NAIL. SET ROUND ODOT MON BOX OVER PIN.

NOVEMBER 22, 2016

SET ROUND ODOT MONUMENT
 BOX OVER IRON PIN IN IRON PIPE

