

OTTAWA COUNTY ENGINEERS OFFICE

REFERENCE NO. 34-7-13-I
SE CORNER POST SEC. 34
CLAY TWP.
SHEET 1 OF 1.

ROUTE: STATE ROUTE #163
@ T-7 MARTIN WILLISTON RD.

TOWNSHIP: CLAY

SECTION: 34

T 7 NR 13 E.

PERSONNEL:

M. WITTMAN, P.S.
J. ALLEN
R. NUHGER, P.S. - ODOT
S. CODER, PS. - ODOT
J. RHODES - ODOT


NORTHING:

EASTING:

DATUM:

DATE / WEATHER / TEMP:

APRIL 29, 2013
OVERCAST
59° F

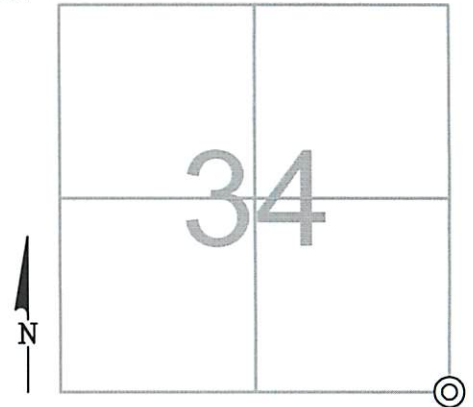

MONUMENT INFORMATION

MONUMENT TYPE: FD. 1" SQ HEAD BOLT IN CONC.
ON SURFACE - BELOW: 0.76'
LEFT - CL PAV'T - RIGHT: 1.82' (SR 163) 1.3' L (C/L T-7)

6" Ø CONCRETE MONUMENT

USED CENTER OF SQUARE HEAD OF BOLT



MISC. INFORMATION

FD ODOT NAIL AND SHINER ON SURFACE, TIED W-
X-TIES AND DUG FOR BRICK NOTED ON RECORD -
FD BOLT IN CONCRETE

NAIL ON SURFACE WAS 0.21' S AND 0.05' E OF
CENTER OF HEAD OF BOLT.

SEPTEMBER 9, 2013

SET MONUMENT BOX OVER
CONCRETE MONUMENT
(ODOT ASSISTANCE)

