

OTTAWA COUNTY ENGINEERS OFFICE

REFERENCE NO. 35-7-13-C
NE CORNER POST SEC. 35
CLAY TWP.
SHEET 1 OF 1.

PERSONNEL:
M. WITTMAN, P.S.
J. ALLEN
J. TIMMONS

DATE / WEATHER / TEMP:
JULY 7, 2016
SUNNY
86° F - HUMID

ROUTE: T-214 OPFER-LENTZ RD.
@ T-40 HOLTS-EAST RD.

TOWNSHIP: CLAY


SECTION: 35

T 7 NR 13 E.

NORTHING:

EASTING:

DATUM:

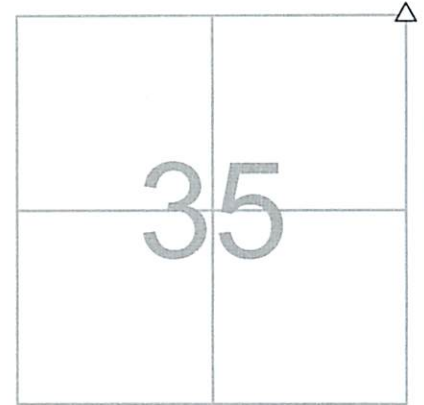

MONUMENT INFORMATION

MONUMENT TYPE: FD 7-1/2" x 8-1/2" LIMESTONE
ON SURFACE - BELOW: 1.96'
LEFT - CL PAV'T - RIGHT: 5.40' (OPFER-LENTZ RD.)
LEFT - CL PAV'T - RIGHT: 3.50' (HOLTS-EAST RD.)

FD DRILL HOLE IN STONE, USED DRILL HOLE.



MISC. INFORMATION

FD RR SPIKE 0.23' BELOW SURFACE, TIED W/ X-TIES
AND DUG FOR STONE. FD 1" SQUARE WOOD HUB
ON EAST SIDE OF STONE.

RR SPIKE WAS 0.08' SOUTH AND 0.12' EAST OF
DRILL HOLE IN STONE.

JULY 7, 2016

SET 1" SQUARE IRON PIN
IN MONUMENT BOX OVER
STONE

