

OTTAWA COUNTY ENGINEERS OFFICE

REFERENCE NO. 36-7-13-E
CENTER POST SECTION 36
CLAY TWP.
SHEET 1 OF 1.

ROUTE: T-231 WHITNEY RD.

TOWNSHIP: CLAY

SECTION: 36

T 7 NR 13 E.

NORTHING:

EASTING:


DATUM:

PERSONNEL:

M. WITTMAN, P.S.
J. ALLEN
J. TIMMONS

DATE / WEATHER / TEMP:

JULY 12, 2016
SUNNY - S
92° F - HUMID

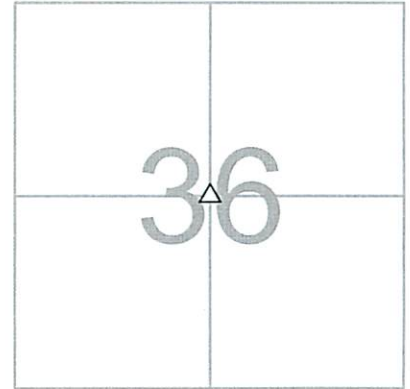

MONUMENT INFORMATION

MONUMENT TYPE: FD 11" x 6" STONE
ON SURFACE - BELOW: 0.79'
LEFT - CL PAVT' - RIGHT: 5.80'

TRIANGULAR SHAPED STONE WITH DRILL HOLE.



MISC. INFORMATION

FD RR SPIKE 0.08' BELOW SURFACE, TIED W/
X-TIES AND DUG FOR STONE.

RR SPIKE WAS 0.01' NORTH AND 0.06' EAST OF
DRILL HOLE IN STONE.

JULY 12, 2016

SET 1" MONUMENT BOX
OVER STONE

