

# OTTAWA COUNTY ENGINEERS OFFICE

REFERENCE NO. 36-7-13-F  
EAST QUARTER POST SEC. 36  
CLAY TWP.  
SHEET 1 OF 1.

ROUTE: C-213 NISSEN RD.  
@ T-231 WHITNEY RD.

TOWNSHIP: CLAY

SECTION: 36

T 7 NR 13 E.

NORTHING:

EASTING:


DATUM:

**PERSONNEL:**

M. WITTMAN, P.S.  
J. ALLEN  
M. ULLRICH  
S. ULLRICH

**DATE / WEATHER / TEMP:**

JULY 1, 2008  
SUNNY  
70° F

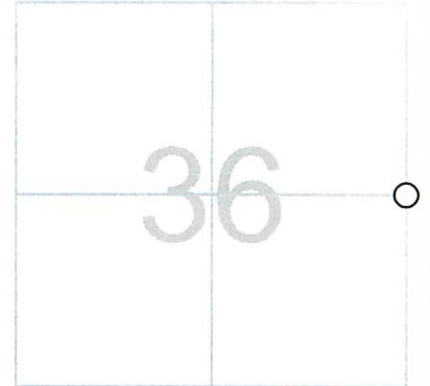

MONUMENT INFORMATION

MONUMENT TYPE: FD 1" Ø IRON PIN  
ON SURFACE - BELOW: 0.41'  
LEFT - CL PAV'T - RIGHT: 1.40'  
PLACED DRILL HOLE IN CENTER OF PIN



MISC. INFORMATION

JULY 1, 2008

SET MONUMENT BOX  
OVER IRON PIN

