

OTTAWA COUNTY ENGINEERS OFFICE

REFERENCE NO. 36-7-13-G
 SW CORNER POST SEC. 36
 CLAY TWP.
SHEET 1 OF 1.

ROUTE: STATE ROUTE #163
 @ T-214 OPFER-LENTZ RD.

TOWNSHIP: CLAY


SECTION: 36

T 7 **NR** 13 **E.**

NORTHING:

EASTING:

DATUM:

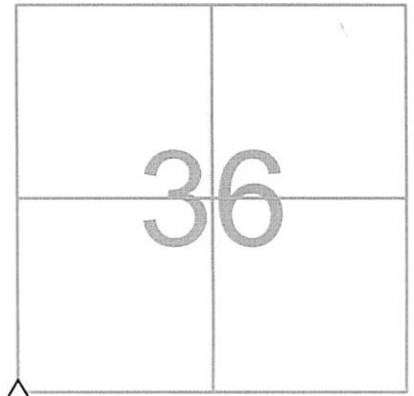

PERSONNEL:

- M. WITTMAN, P.S.
- M. BROUGH, C. MILLER
- R. NUHFER, P.S. - ODOT
- D. HOHMAN, P.S. - ODOT
- T. ROUSOS - ODOT

DATE / WEATHER / TEMP:

MAY 1, 2013
 SUNNY - SE
 70° F

MONUMENT INFORMATION

MONUMENT TYPE: FD 7" X 7" BROKEN LIMESTONE
 ON SURFACE - BELOW: 1.40'
LEFT - CL PAV'T - RIGHT: 1.10' (SR 163) 5.5' L (CL T-213)

 USED FAINT "X" IN HIGH POINT OF STONE, SET
 DRILL HOLE IN CENTER OF "X"



MISC. INFORMATION

FD PK AND SHINER ON SURFACE, TIED W/ X-TIES AND DUG
 FOR STONE. FD PK AND WAHSER 0.25' BELOW SURFACE.
 FD PK NAIL 0.39' BELOW SURFACE, 0.03' SOUTH AND 0.01' E
 OF SURFACE NAIL. SURFACE NAIL WAS 0.65' SOUTH AND
 0.55' WEST OF "X" IN STONE.
8-28-13: SET 1" Ø X 12" LONG IRON PIN IN FLOODED SAND
 IN 6" Ø PVC IN MONUMENT BOX WITH ODOT AND SHELLY
 CO. ASSISTANCE.

AUGUST 28, 2013

SET 1" Ø IRON PIN IN
 MONUMENT BOX
 OVER STONE

