

# OTTAWA COUNTY ENGINEERS OFFICE

REFERENCE NO. 36-7-13-1  
SE CORNER POST SECTION 36  
CLAY TWP.  
SHEET 1 OF 1.

ROUTE: C-213 NISSEN RD.  
@ S-163 STATE ROUTE 163

TOWNSHIP: CLAY

SECTION: 36

T 7 NR 13 E.

PERSONNEL:  
M. WITTMAN, P.S.  
J.D. BARNES


NORTHING:

EASTING:

DATUM:

DATE / WEATHER / TEMP:

APRIL 22, 2007  
SUNNY S  
80° F

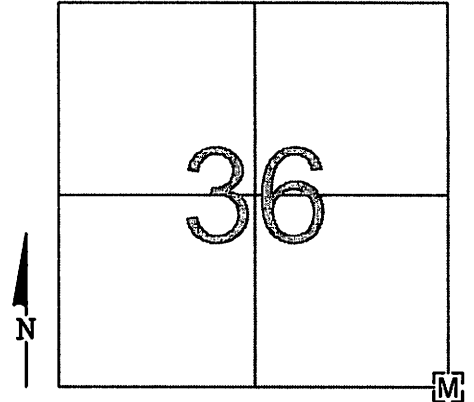

## MONUMENT INFORMATION

MONUMENT TYPE: FD 1-1/4" IRON PIN IN MON BOX  
ON SURFACE - BELOW:  
LEFT - CL PAVT - RIGHT:

## MISC. INFORMATION

8-26-71: FD 8-1/2" x 8-1/2" x 14-1/2" STONE 16"  
BELOW SURFACE - SET IRON PIN IN MONUMENT  
BOX PER OTTAWA COUNTY STONE RECORDS

PHOTO OF STONE NOT AVAILABLE

